


# Slade Lane - As Built

This plan shows the changes made to the junction of Moseley Road and Slade Lane:

- New controlled pedestrian crossings as part of junction improvement
- New 'Rain Garden' drainage
- New footway build outs
- New parking area.

Due to presence of a lot of underground services such as water pipes, electricity cables etc. we were unable to accommodate one of the proposed rain gardens instead we have installed a wider footway area at that location with the other rain garden already installed.

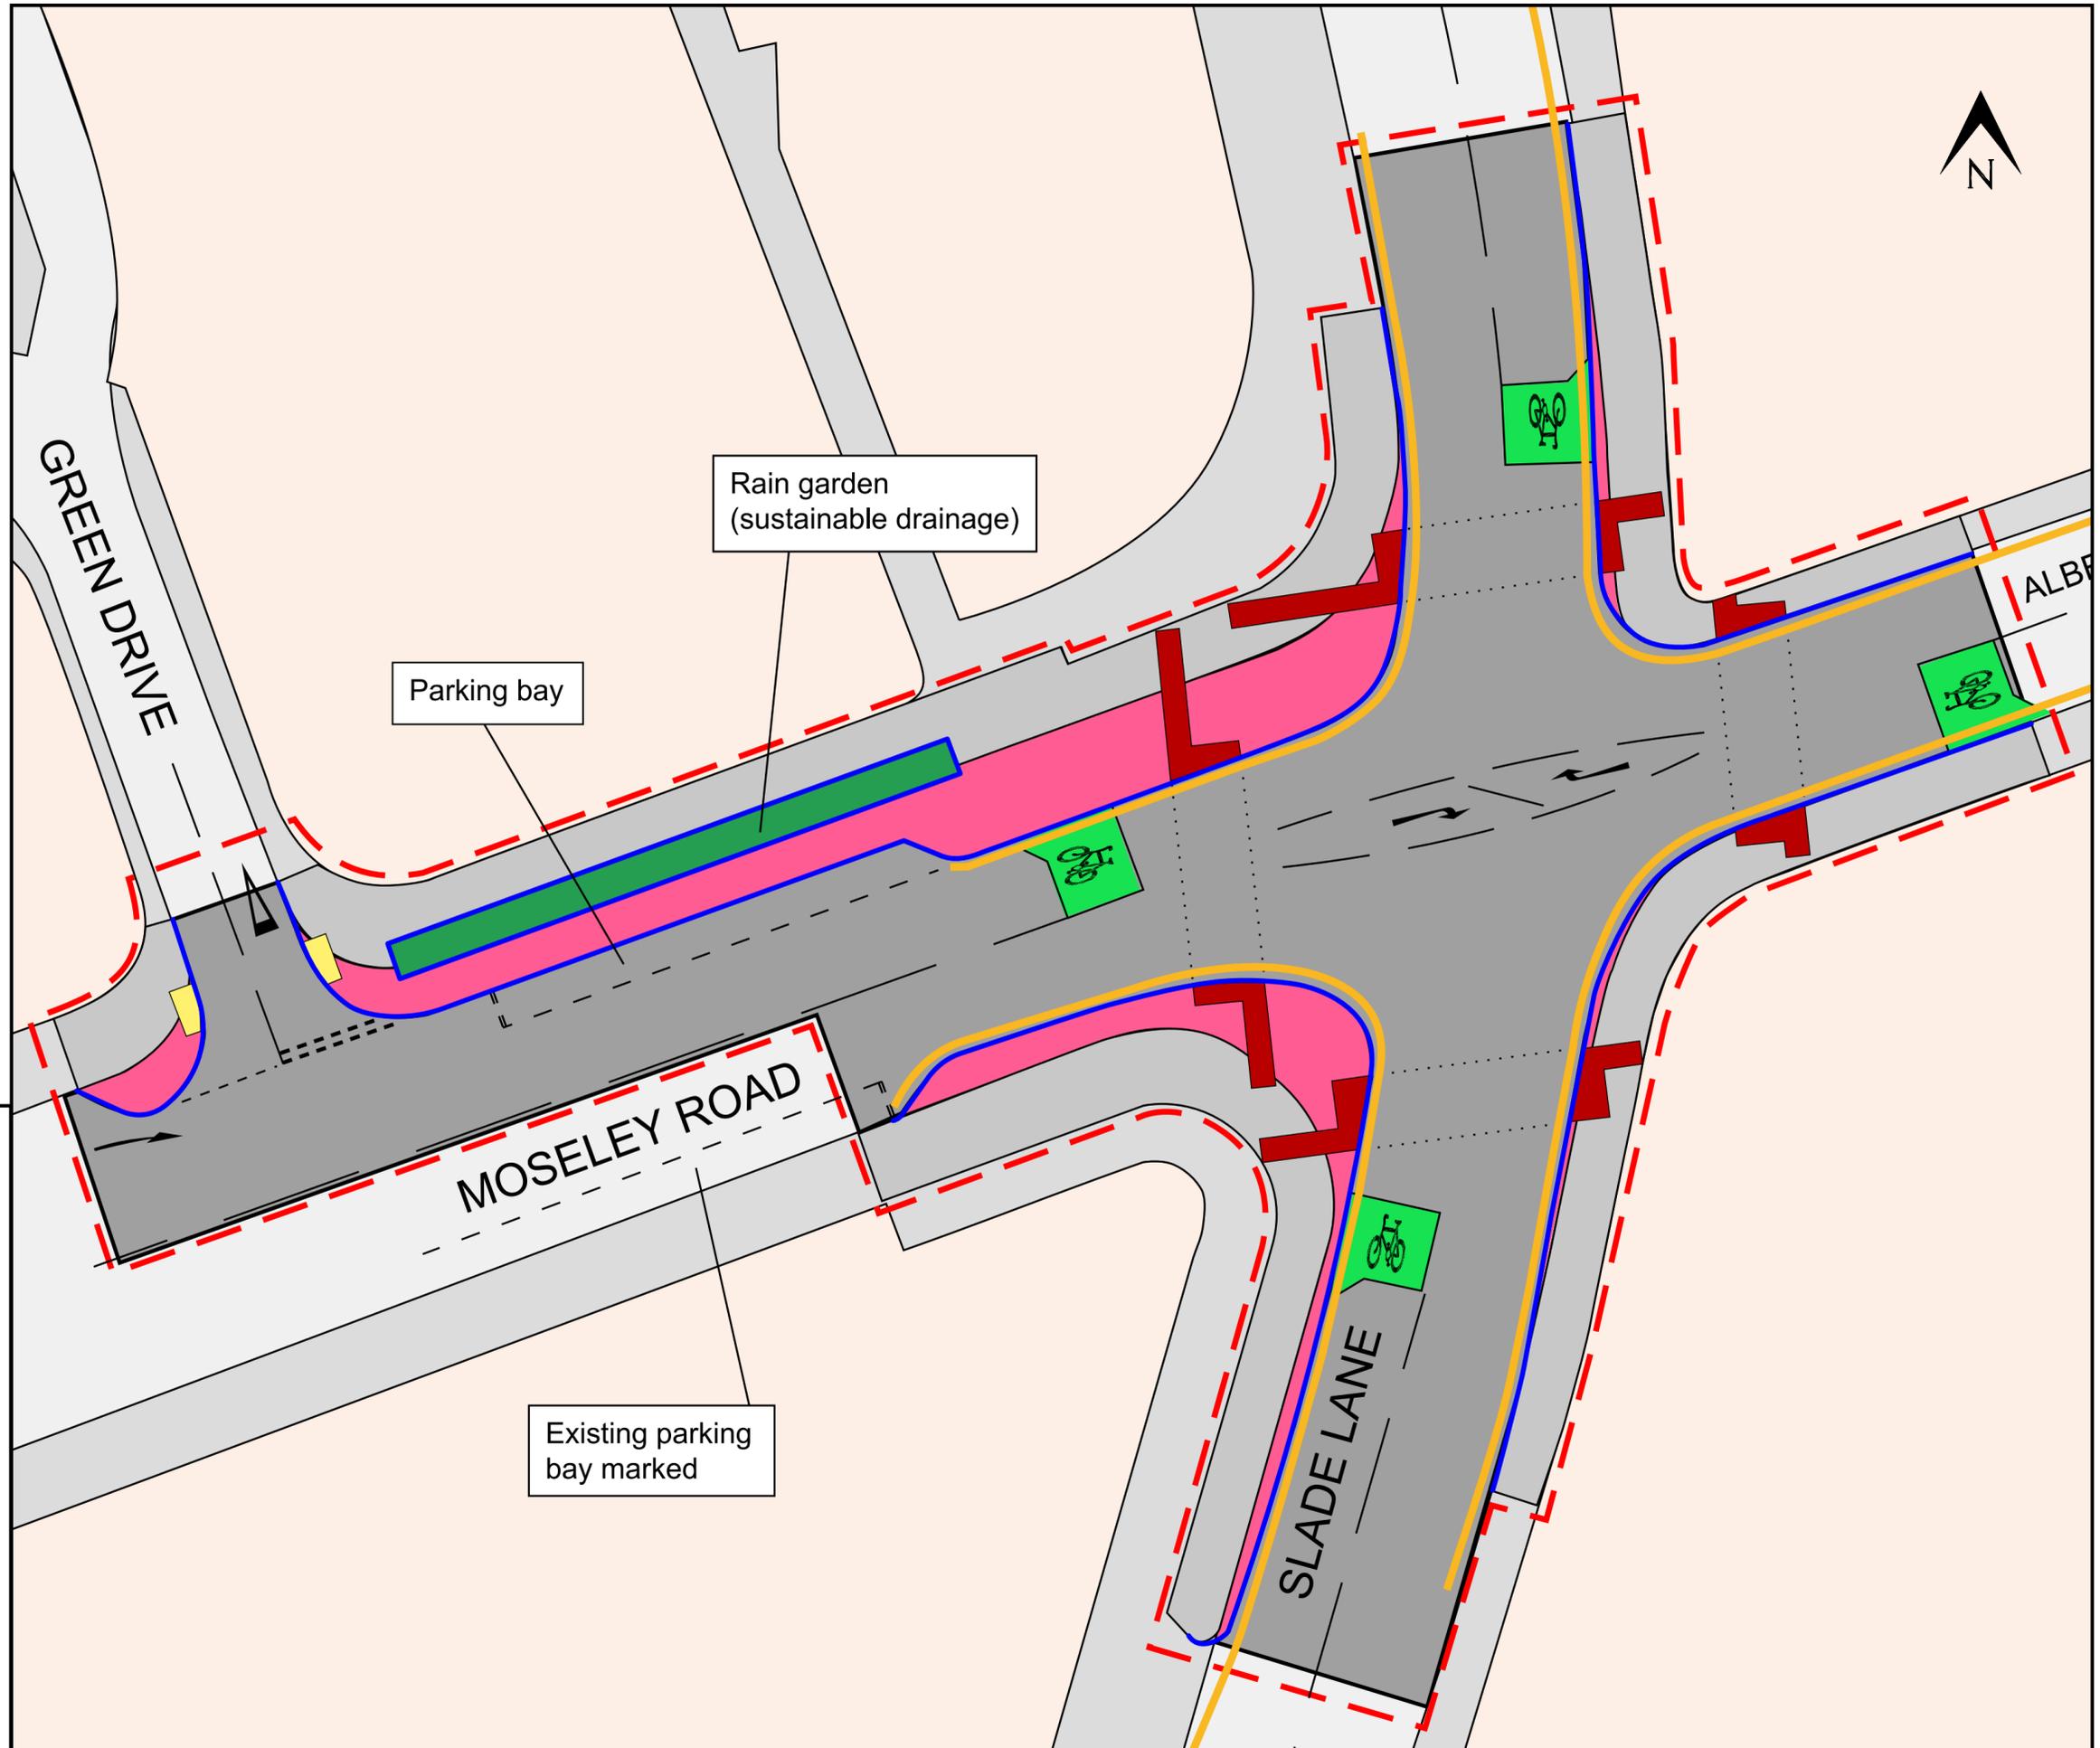

## KEY

- Carriageway resurfaced
- Footway resurfaced
- Rain garden
- Uncontrolled tactile paving
- Controlled tactile paving
- Footway buildout
- Kerbs
- Site boundary
- Double yellow lines and double kerb blips (no loading)