

Grangethorpe Drive

This plan shows the proposed changes to take place on Grangethorpe Drive.

- Raised continuous walkways on side street junctions of Burnside Drive, Orville Drive, and Lynton Drive.
- Raised table on Grangethorpe Drive, opposite Orville Drive.
- Removal of existing road humps.
- New flat top hump on the eastern end of Grangethorpe Drive.
- 20mph road markings along the length of Grangethorpe Drive

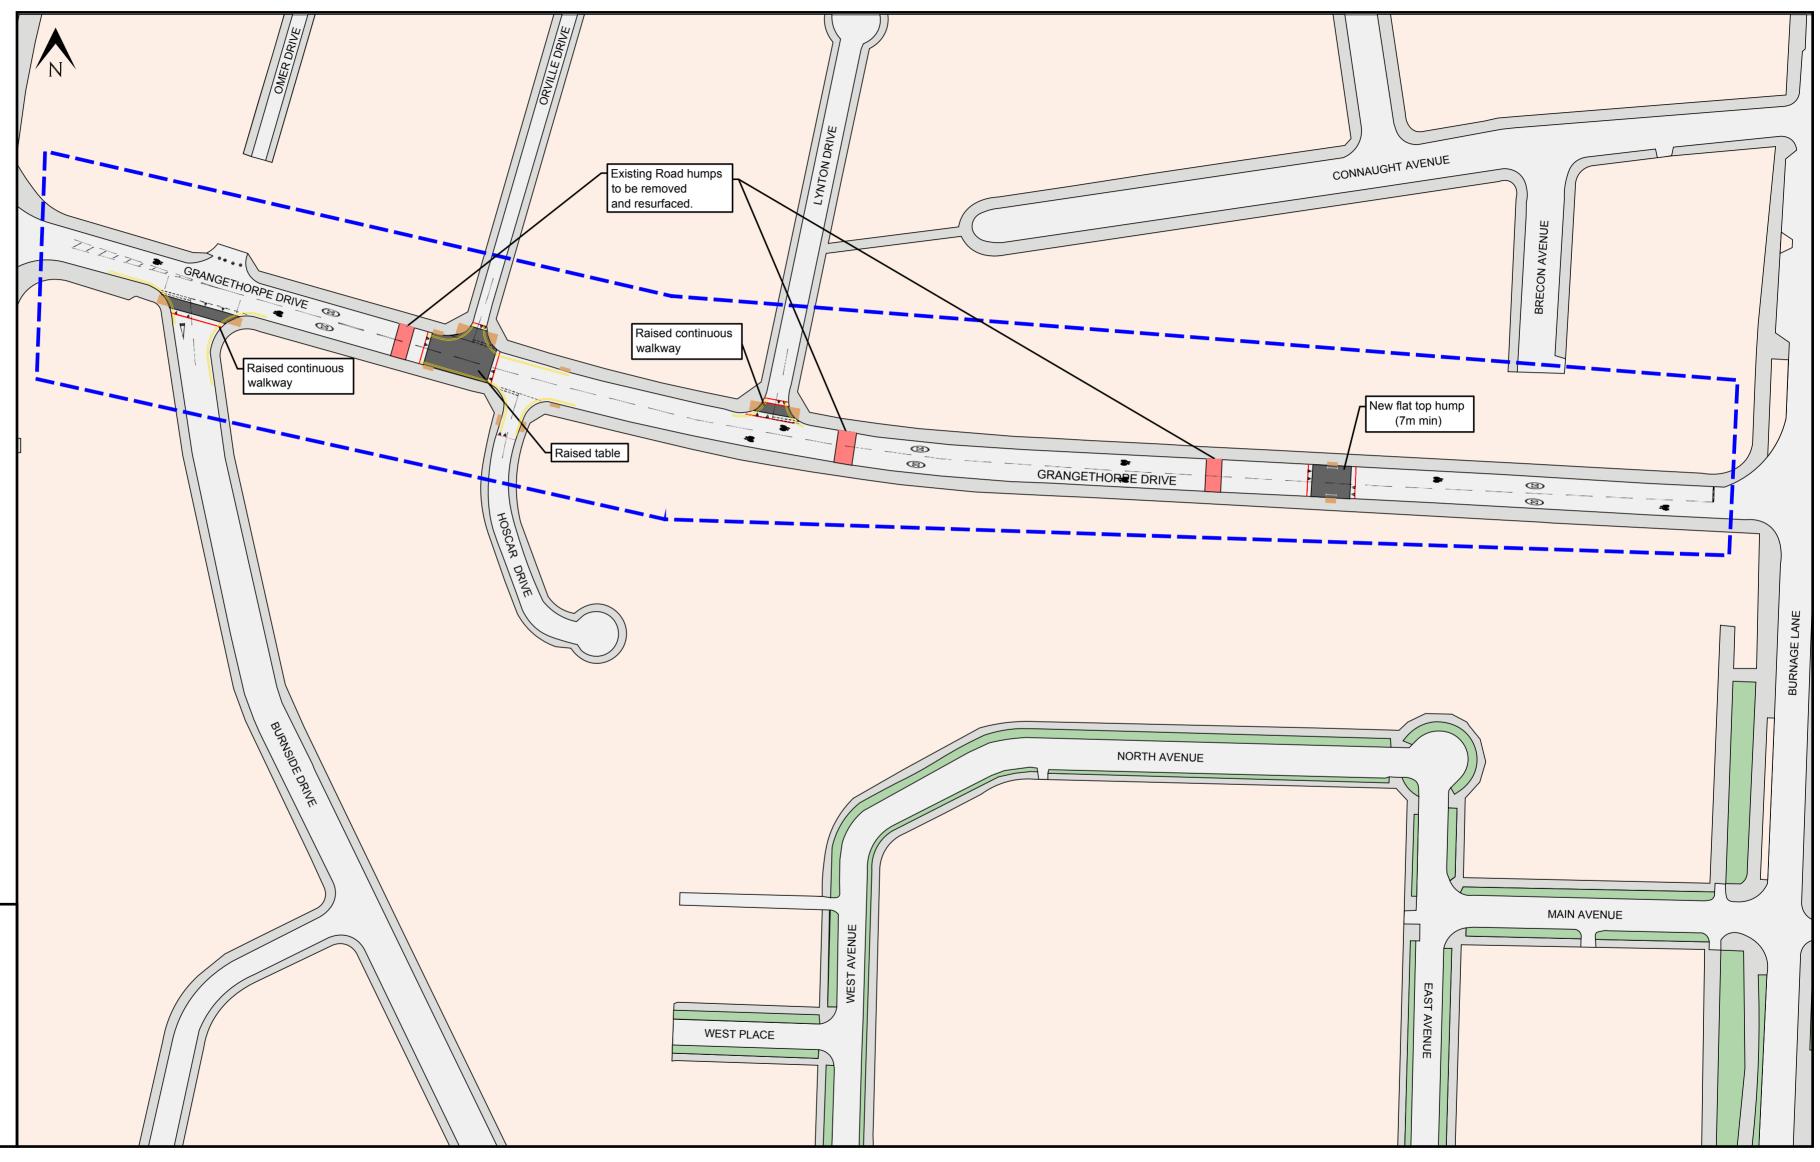

KEY

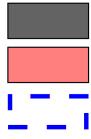

Raised table

Existing speed cushion to be removed

20mph Zone